

THIS DRAWING IS TO BE READ IN CONJUNCTION WITH S.M. NO. (GM 310)


IKHS : PN
 E3 / D/P/M / GM / AGM
 P.M. / P.M.
 E.M.P. / O.M.R. APPROVED
 Reference No. : PN - FD 33200 - ELV - 517-02
 Revision No. : B
 Approved by : *Suzanne Ho*
 Date : 1/6/2004

BLOCK 1

BLOCK 2

BLOCK 3

BLOCK 4

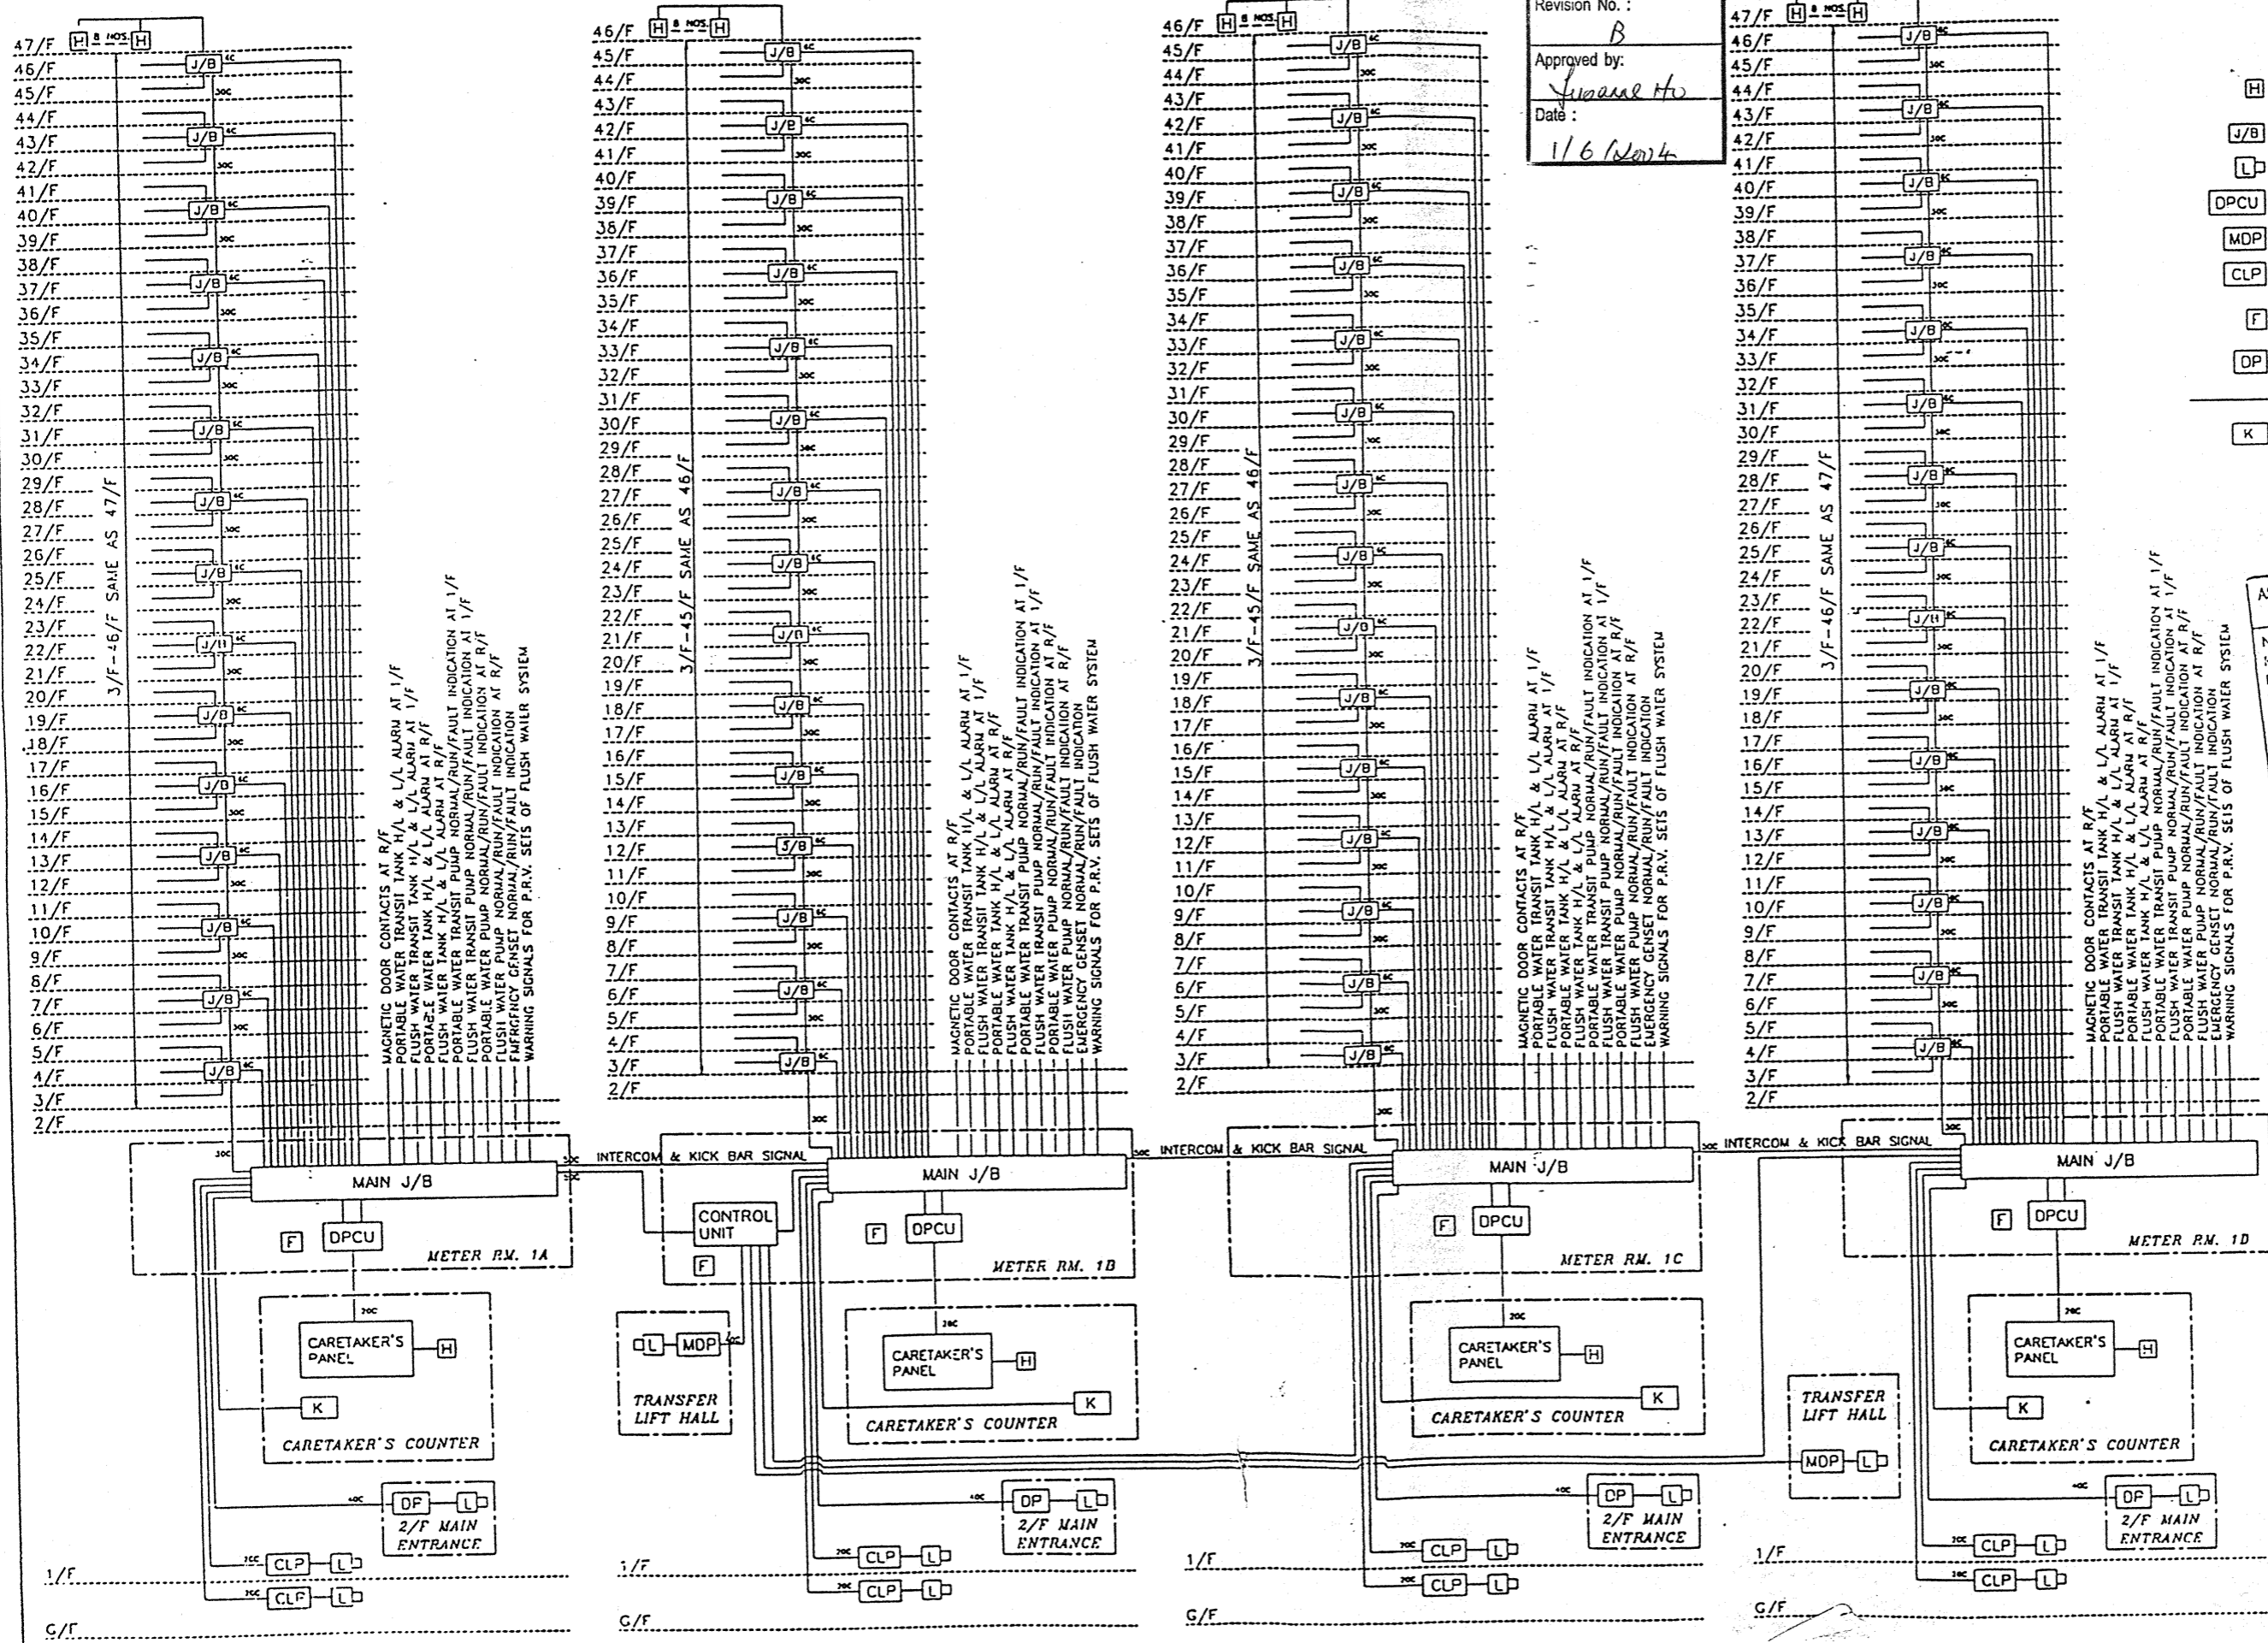

- LEGEND**
- [H] DOORPHONE HANDSET C/W PANIC ALARM BUTTON
 - [J/B] JUNCTION BOX
 - [L] ELECTRIC DOOR LOCK
 - [DPCU] DOORPHONE CONTROL UNIT
 - [MDP] MASTER DOORPHONE PANEL
 - [CLP] COMBINATION LOCK PANEL
 - [F] 13A FUSED CONNECTION UNIT (PROVIDED BY ELECTRICAL CONTRACTOR)
 - [DP] DOORPHONE PANEL
 - PVC 0.5mm DIA. MULTICORE CABLE
 - [K] KICKBAR UNIT

ASSOCIATED CONSULTING ENGINEERS HONG KONG

NO EXCEPTIONS TAKEN
 MAKE CORRECTIONS NOTED
 REVISE & RESUBMIT
 REJECTED

Checked by: *[Signature]*
 Date: 29/9/98

Engineer's review is for general compliance with the design concept and contract documents. Markings on drawings or the back thereof shall not be construed as relieving the Contractor of compliance with the project plans and specifications. The Contractor remains responsible for details and accuracy of construction and completion of the work.

03-07-98-1-8 AS-FITTED
 08-01-99 A GENERAL REVISION
 DATE NO. REVISION

PROJECT: TSEUNG KWAN O AREA 24

TITLE: SCHEMATIC WIRING DIAGRAM OF DOORPHONE SYSTEM FOR BLOCKS 1 TO 4

TRIDANT ENGINEERING CO., LTD
 403, NEW WORLD CENTRE, 20, SALISBURY ROAD, TOWER 12A, HONG KONG, TEL: 2334188

DATE: 17-7-96 SCALE: N.T.S.
 DRAWN BY: K.Y.S-A CHECKED BY: S.Y. LAU
 DRAWING NO.: AS-J3200-ELV-517-02